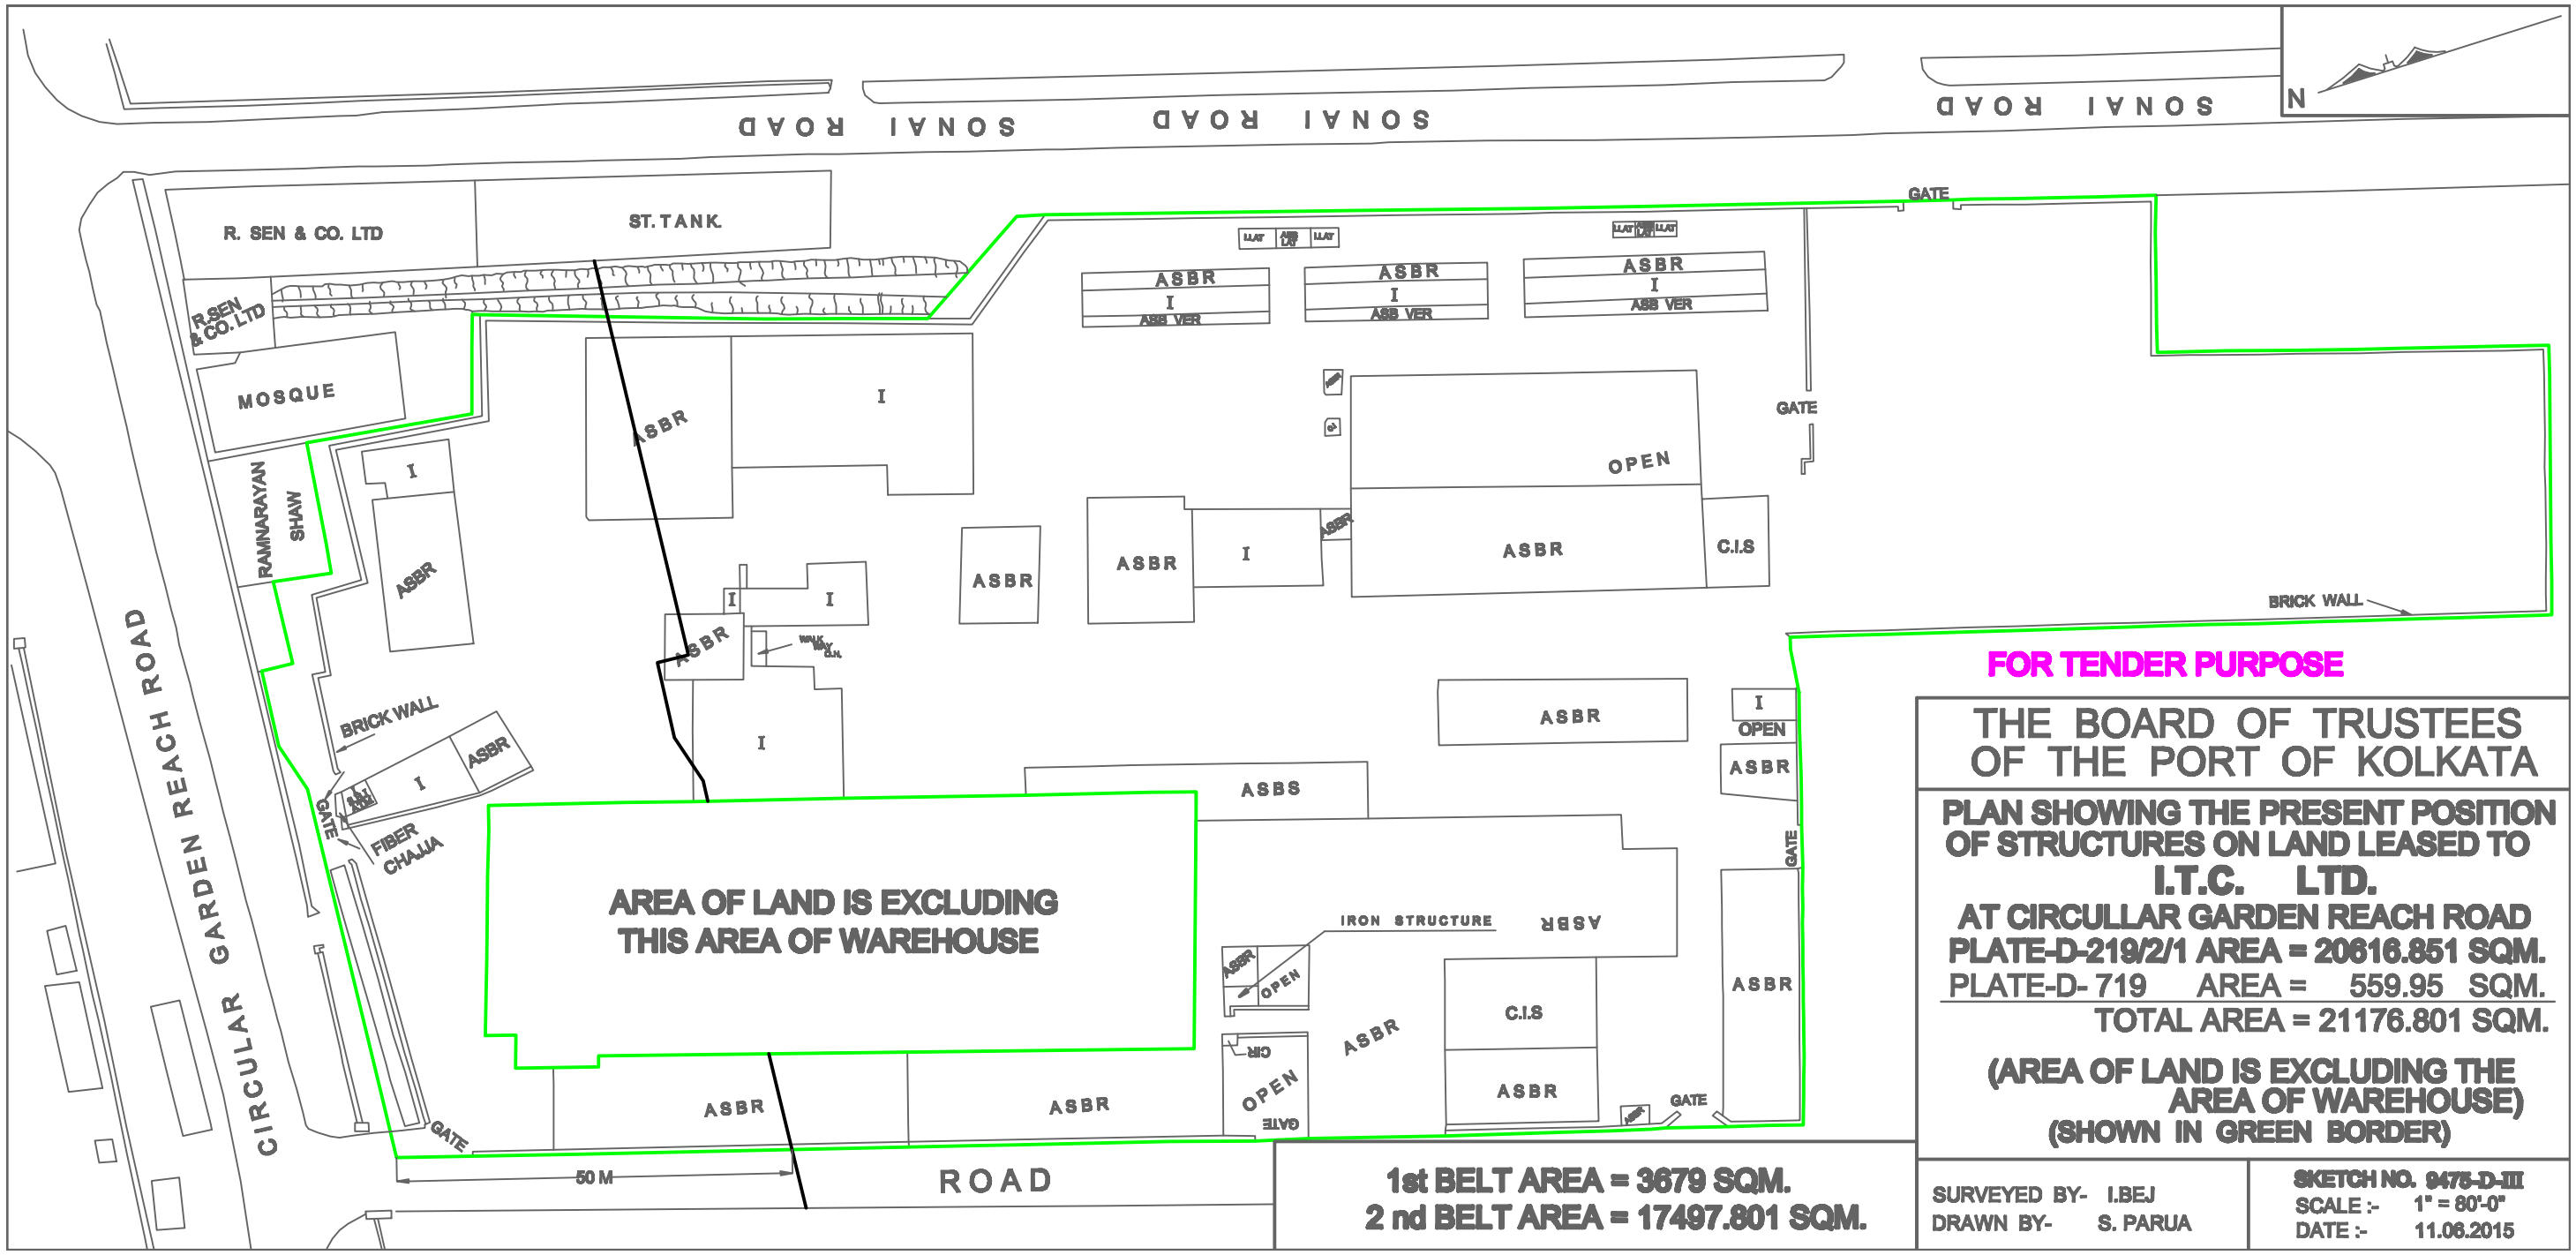
SONAI ROAD
SONAI ROAD
SONAI ROAD
N
R. SEN & CO. LTD
ST. TANK
R.SEN & CO. LTD
MOSQUE
RAMNARAYAN SHAW
CIRCULAR GARDEN REACH ROAD
BRICK WALL
FIBER CHALLA
GATE
ASBR
I
ASBS
OPEN
C.I.S
IRON STRUCTURE
ASB VER
BRICK WALL
AREA OF LAND IS EXCLUDING THIS AREA OF WAREHOUSE
50 M
ROAD
FOR TENDER PURPOSE
THE BOARD OF TRUSTEES OF THE PORT OF KOLKATA
PLAN SHOWING THE PRESENT POSITION OF STRUCTURES ON LAND LEASED TO
I.T.C. LTD.
AT CIRCULLAR GARDEN REACH ROAD
PLATE-D-219/2/1 AREA = 20616.851 SQM.
PLATE-D- 719 AREA = 559.95 SQM.
TOTAL AREA = 21176.801 SQM.
(AREA OF LAND IS EXCLUDING THE AREA OF WAREHOUSE)
(SHOWN IN GREEN BORDER)
1st BELT AREA = 3679 SQM.
2 nd BELT AREA = 17497.801 SQM.
SURVEYED BY- I.BEJ
DRAWN BY- S. PARUA
SKETCH NO. 9475-D-III
SCALE :- 1" = 80'-0"
DATE :- 11.06.2015

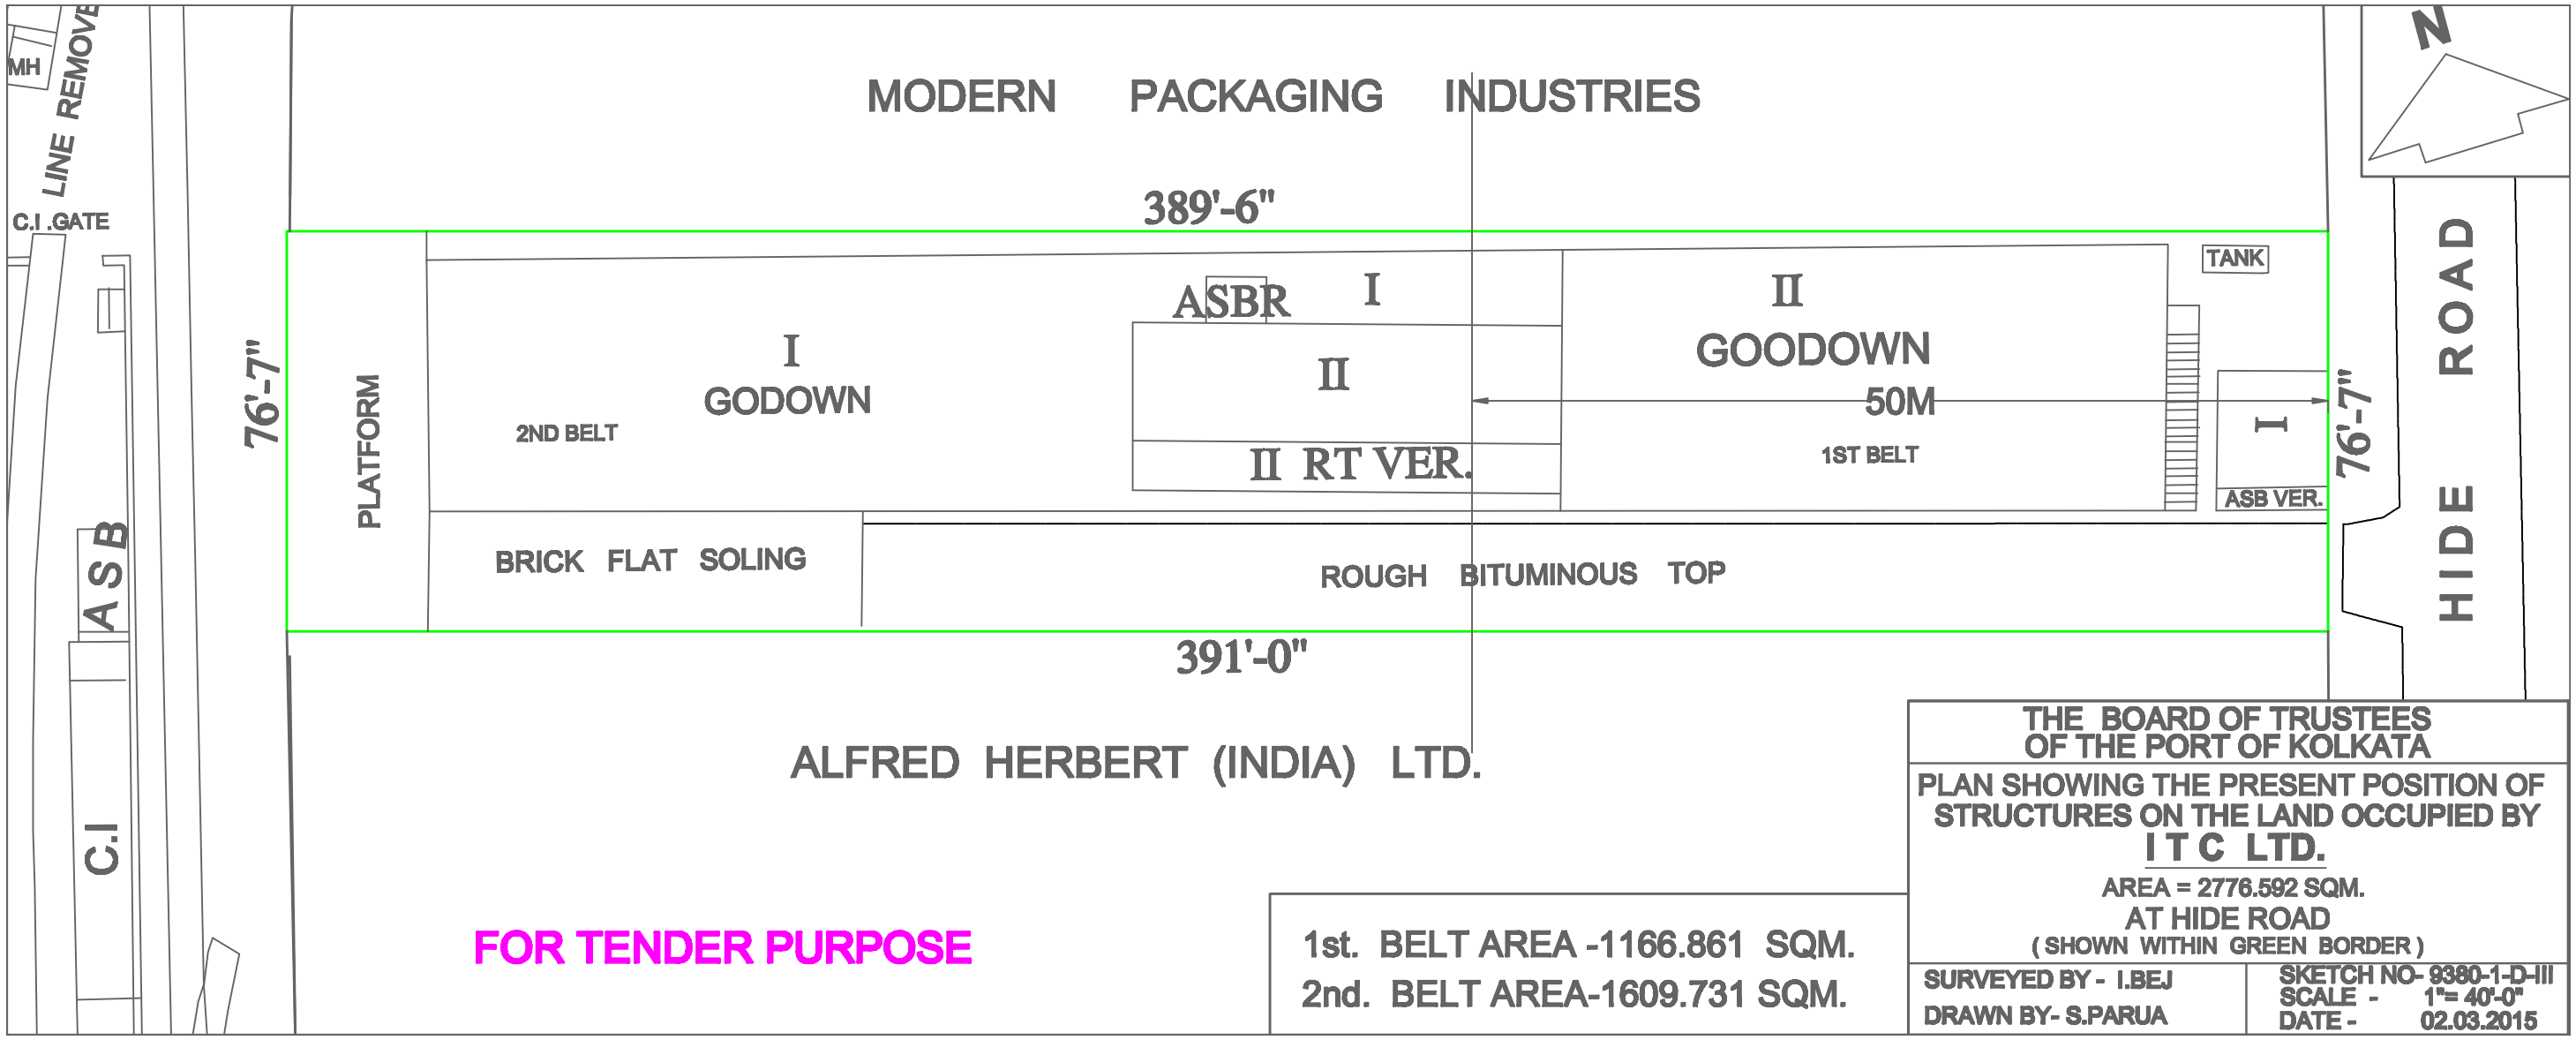
MODERN PACKAGING INDUSTRIES
389'-6"
391'-0"
76'-7"
76'-7"
PLATFORM
I
GODOWN
2ND BELT
ASBR
I
II
II RT VER.
II
GOODOWN
50M
1ST BELT
TANK
I
ASB VER.
BRICK FLAT SOLING
ROUGH BITUMINOUS TOP
ALFRED HERBERT (INDIA) LTD.
HIDE ROAD
N
MH
LINE REMOVE
C.I .GATE
ASB
C.I
FOR TENDER PURPOSE
1st. BELT AREA -1166.861 SQM.
2nd. BELT AREA-1609.731 SQM.
THE BOARD OF TRUSTEES
OF THE PORT OF KOLKATA
PLAN SHOWING THE PRESENT POSITION OF
STRUCTURES ON THE LAND OCCUPIED BY
I T C LTD.
AREA = 2776.592 SQM.
AT HIDE ROAD
(SHOWN WITHIN GREEN BORDER)
SURVEYED BY - I.BEJ
DRAWN BY- S.PARUA
SKETCH NO- 9380-1-D-III
SCALE - 1"= 40'-0"
DATE - 02.03.2015